


Appendix 9 : As-Built Drawing of Tiriganiaq 02 Open Pit Access Road

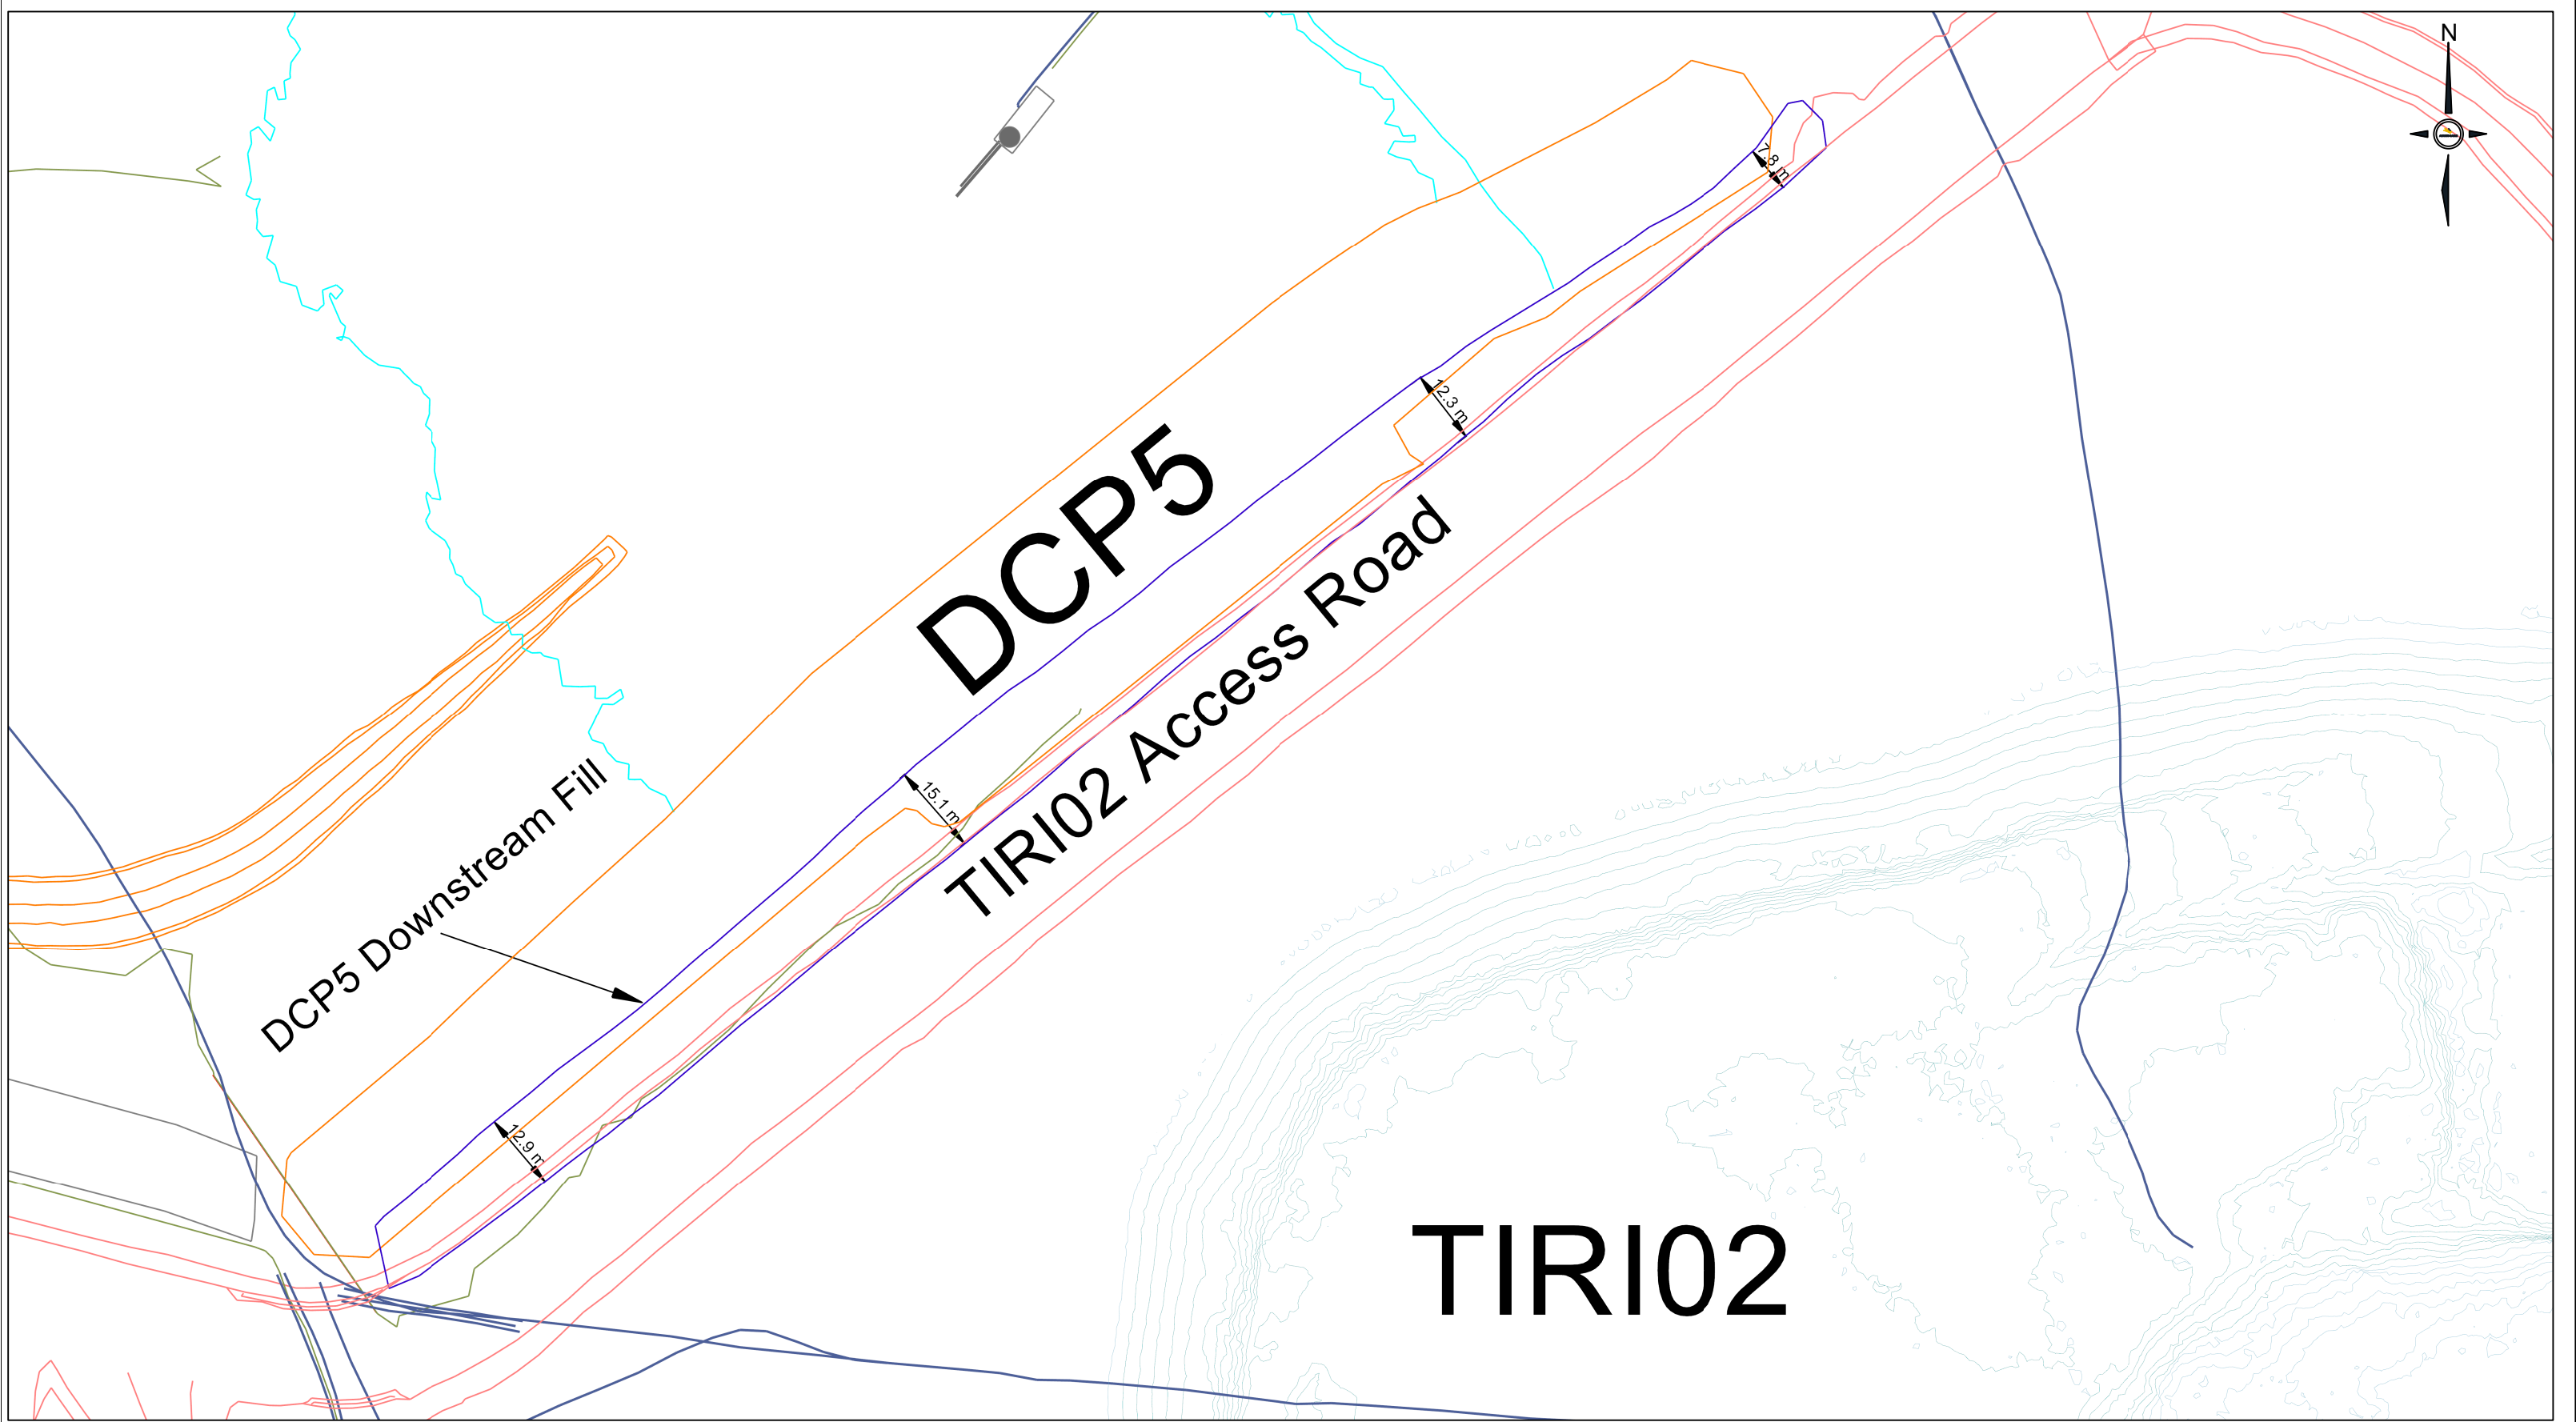

	DESSINÉ PAR/DRAWN BY	DATE	TITRE / TITLE AGNICO EAGLE – MELIADINE DIVISION D–CP5 Downstream Fill As–Built	
	VÉRIFIÉ PAR/CHECKED BY	DATE		
	APPROUVÉ PAR/APPROVED BY	DATE		
		ÉCHELLE/SCALE 1:1000	FEUILLE/SHT 1/1	No. DESSIN/DRAWING NO. DRAWING–NO
		REVISION A		